

The State of Wisconsin

Office of the Secretary of State

VILLAGE 419

VILLAGE OF STRUM

COUNTY OF TREMPLEAU

ANNEXATION ORDINANCE NUMBER 91

FILED JANUARY 13, 2003

A Community in Unity

Village of Strum

Village of Strum
202 5th Avenue South
P.O. Box 25
Strum, WI 54770

Phone: 715-695-3601


Fax: 715-695-3510

Email: strumvc@triwest.net

Web Site: www.triwest.net/~strumpd

December 31, 2002

Secretary of State
PO Box 7848
Madison, WI 54770

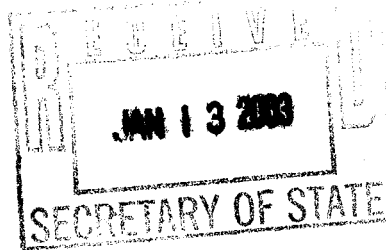

To Whom It May Concern:

Enclosed are copies of Ordinances numbered ⁹¹~~91~~ and ⁹²~~92~~ for the Village of Strum. The Village recently purchased a 32-acre site to put a new well on and develop for residential homes. The property owners' adjoining this property also wish to become part of the village. The Belmores on County Rd D, who are also adjoining village property, signed the unanimous petition to become part of the village. I have included a plat and scaled map of all three areas. If you have any questions you can call me at 715-695-3601.

Sincerely,

Tina Kay Nelson

Tina Kay Nelson
Clerk

Enclosures

AN ORDINANCE PROVIDING FOR DIRECT ANNEXATION OF A PORTION OF THE TOWN OF UNITY, TREMPLEALEAU COUNTY, WISCONSIN, TO THE VILLAGE OF STRUM, TREMPLEALEAU COUNTY, WISCONSIN OF REAL ESTATE OWNED BY THE VILLAGE OF STRUM

WHEREAS, on the 14th day of October, 2002, the Village of Strum purchased on a Land Contract the following described parcel:

A parcel of land located in the NW 1/4 of the NE 1/4 of Sec. 20, Township 24 North, Range 8 West described as follows:

Commencing at the NW corner of the aforesaid NW 1/4 of the NE 1/4; thence East 99 feet; thence South 264 feet; thence East 1171.5 feet; thence North 264 feet; thence East 49.5 feet; thence South 1320 feet to the SE corner of the NW 1/4 of the NE 1/4; thence West 1320 feet to the SW corner of the NW 1/4 of the NE 1/4; thence North 1320 feet to the point of beginning.

WHEREAS, the above described parcel of land is contiguous to the boundaries of the Village of Strum.

WHEREAS, it appears in the best interests of the Village of Strum, that the aforescribed Town of Unity territory be annexed to the Village of Strum;

NOW THEREFORE, the Village Board of Strum, Trempealeau County Wisconsin does ordain as follows:

Section 1. Territory Annexed. In accordance with Section 66.0223 of the Wisconsin Statutes, the following described territory in the Town of Unity, Trempealeau County, Wisconsin, is annexed to the Village of Strum, Wisconsin:


A parcel of land located in the NW 1/4 of the NE 1/4 of Sec. 20, Township 24 North, Range 8 West described as follows:

Commencing at the NW corner of the aforesaid NW 1/4 of the NE 1/4; thence East 99 feet; thence South 264 feet; thence East 1171.5 feet; thence North 264 feet; thence East 49.5 feet; thence South 1320 feet to the SE corner of the NW 1/4 of the NE 1/4; thence West 1320 feet to the SW corner of the NW 1/4 of the NE 1/4; thence North 1320 feet to the point of beginning.

Section 2. Effect of Annexation. From and after the date of this ordinance the territory described in Section 1 shall be part of the Village of Strum for any and all purposes provided by law and all persons coming or residing within such territory shall be subject to all ordinances, rules and regulations governing the Village of Strum.

Population 0

Tina Kay Nelson

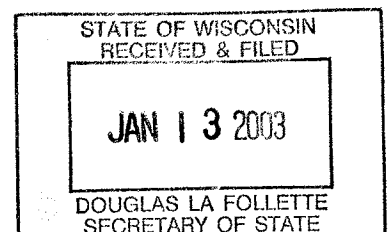

Section 3. Temporary Zoning Classification. The territory annexed to the Village of Strum by this ordinance is temporarily designated to be Residential for zoning purposes and subject to all provisions of the Zoning Ordinance of the Village of Strum relating to such district classifications and to zoning in the Village.

Section 4. Severability. If any provision of this ordinance is invalid or unconstitutional, or if the application of this ordinance to any person or circumstances is invalid or unconstitutional, such invalidity or unconstitutionality shall not affect the other provisions or application of this ordinance which can be given effect without the invalid or unconstitutional provisions or applications.

Section 5. This ordinance shall take effect upon passage and publication as provided by law.

Section 6. The Village Clerk is hereby directed, pursuant to the provision of section 66.0223 Wisconsin Statutes, to file immediately with the Secretary of State 7 certified copies of this ordinance, with 7 copies of the plat. Within 10 days of filing the certified copies, a copy of the Ordinance and plat shall be mailed to the Trempealeau County Clerk.


Dean Boehne (SEAL)
Dean Boehne, President


ATTESTED: Tina Nelson (SEAL)
Tina Nelson, Village Clerk

Introduced: _____

Adopted: 12-30-02

Posted: 12-31-02

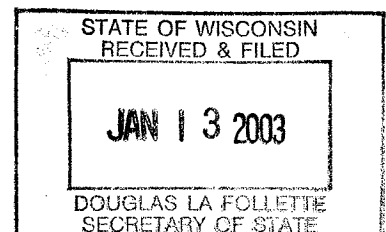

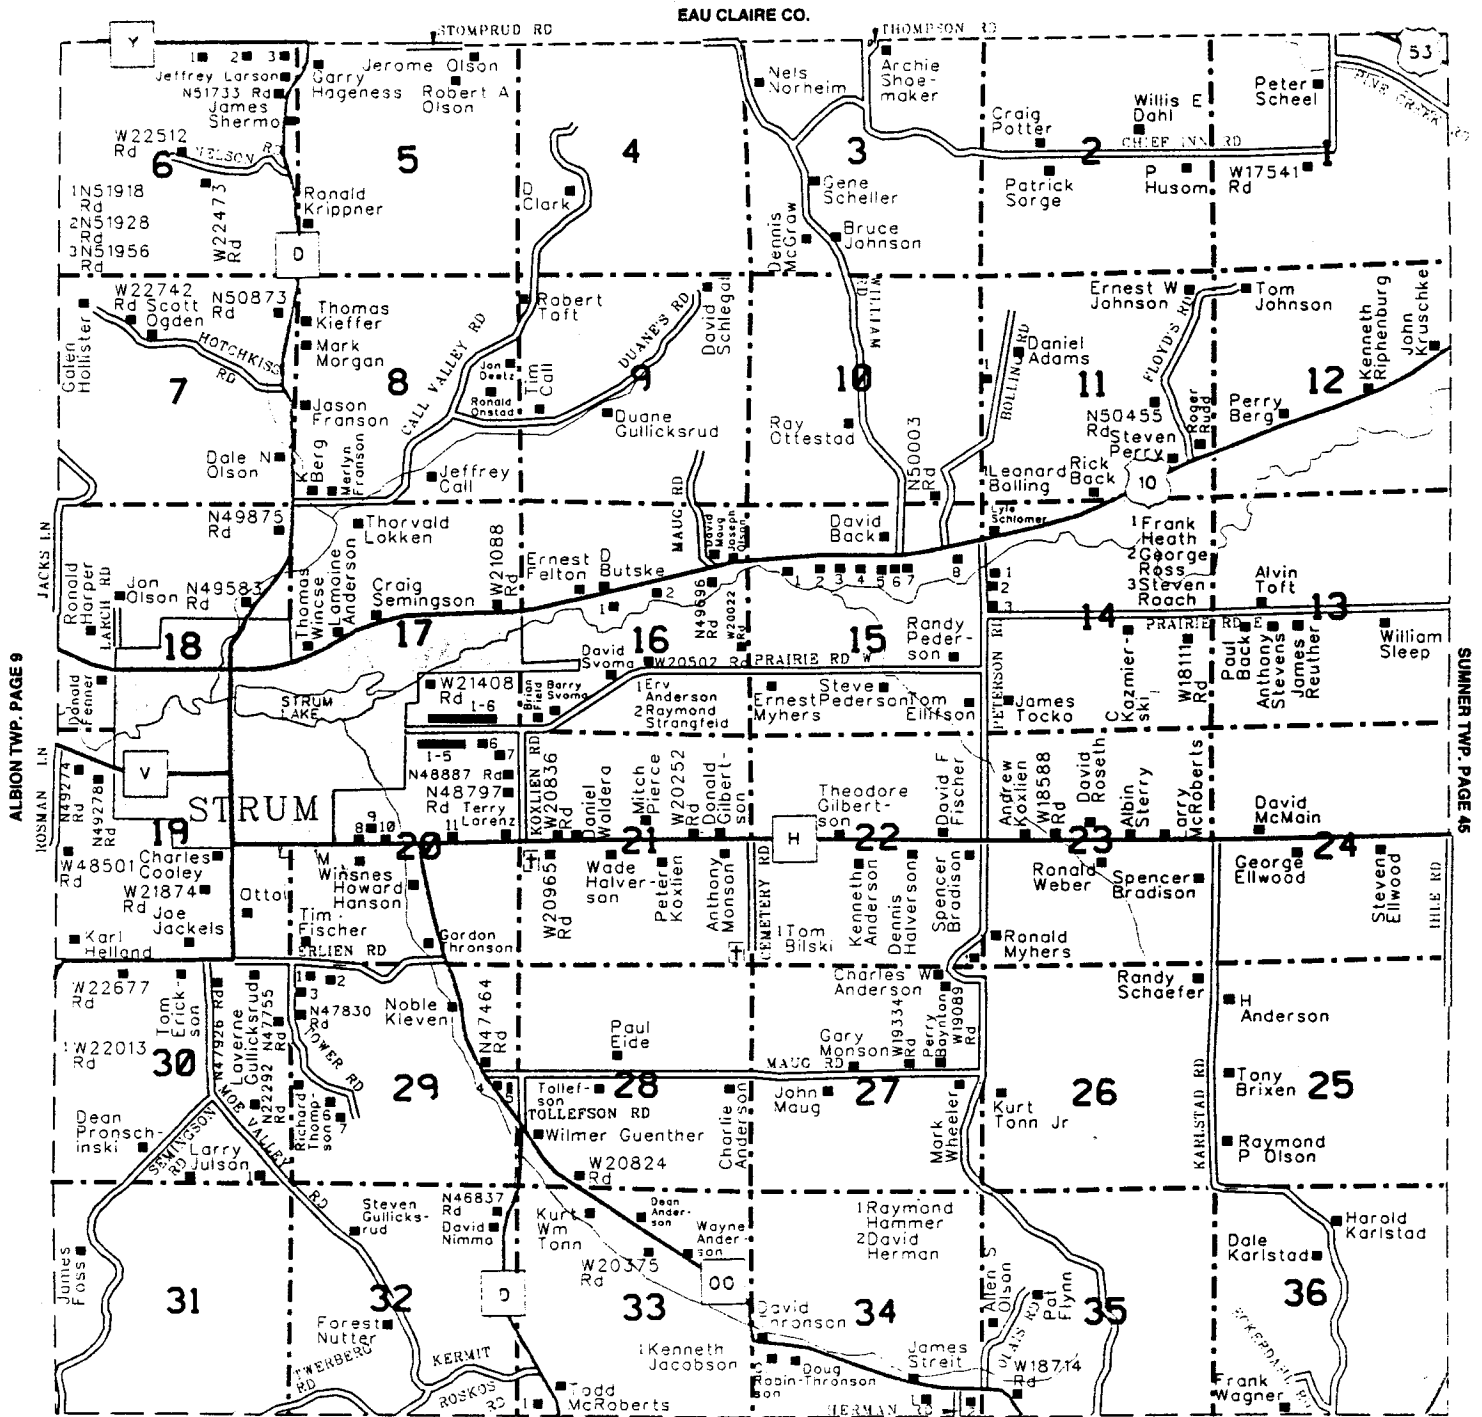

See Page(s) 89-92 For Additional Names.

HALE 'W' TWP. PAGE 35

DUANE'S AUTO CENTER

FOR PEAK ENGINE
PERFORMANCE
**SNAP ON ENGINE
DIAGNOSTICS**
3 YR 75,000 PARTS & LABOR WARRANTY



DUANE KOEHLER
OWNER &
OPERATOR

452-4641

4245 W 4th ST. GOODVIEW, MN

COMPLETE MECHANICAL REPAIR
FOREIGN & DOMESTIC

TUNE-UPS • TRANSMISSIONS • BRAKES
TIRES • SHOCKS • MUFFLERS • ELECTRICAL
STRUT REPAIR • CARBURETORS
ENGINE REBUILDING
WHEEL BALANCING • AIR CONDITIONING




STATE OF WISCONSIN
RECEIVED & FILED

JAN 13 2003


DOUGLAS LA FOLLETTE
SECRETARY OF STATE

Sec. 17

DNR ROW STATE REC. TRAIL

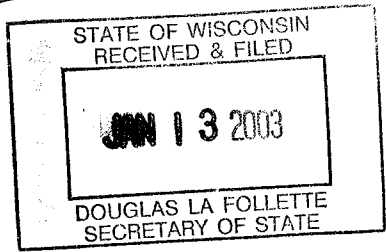

Sec. 17
Sec. 20

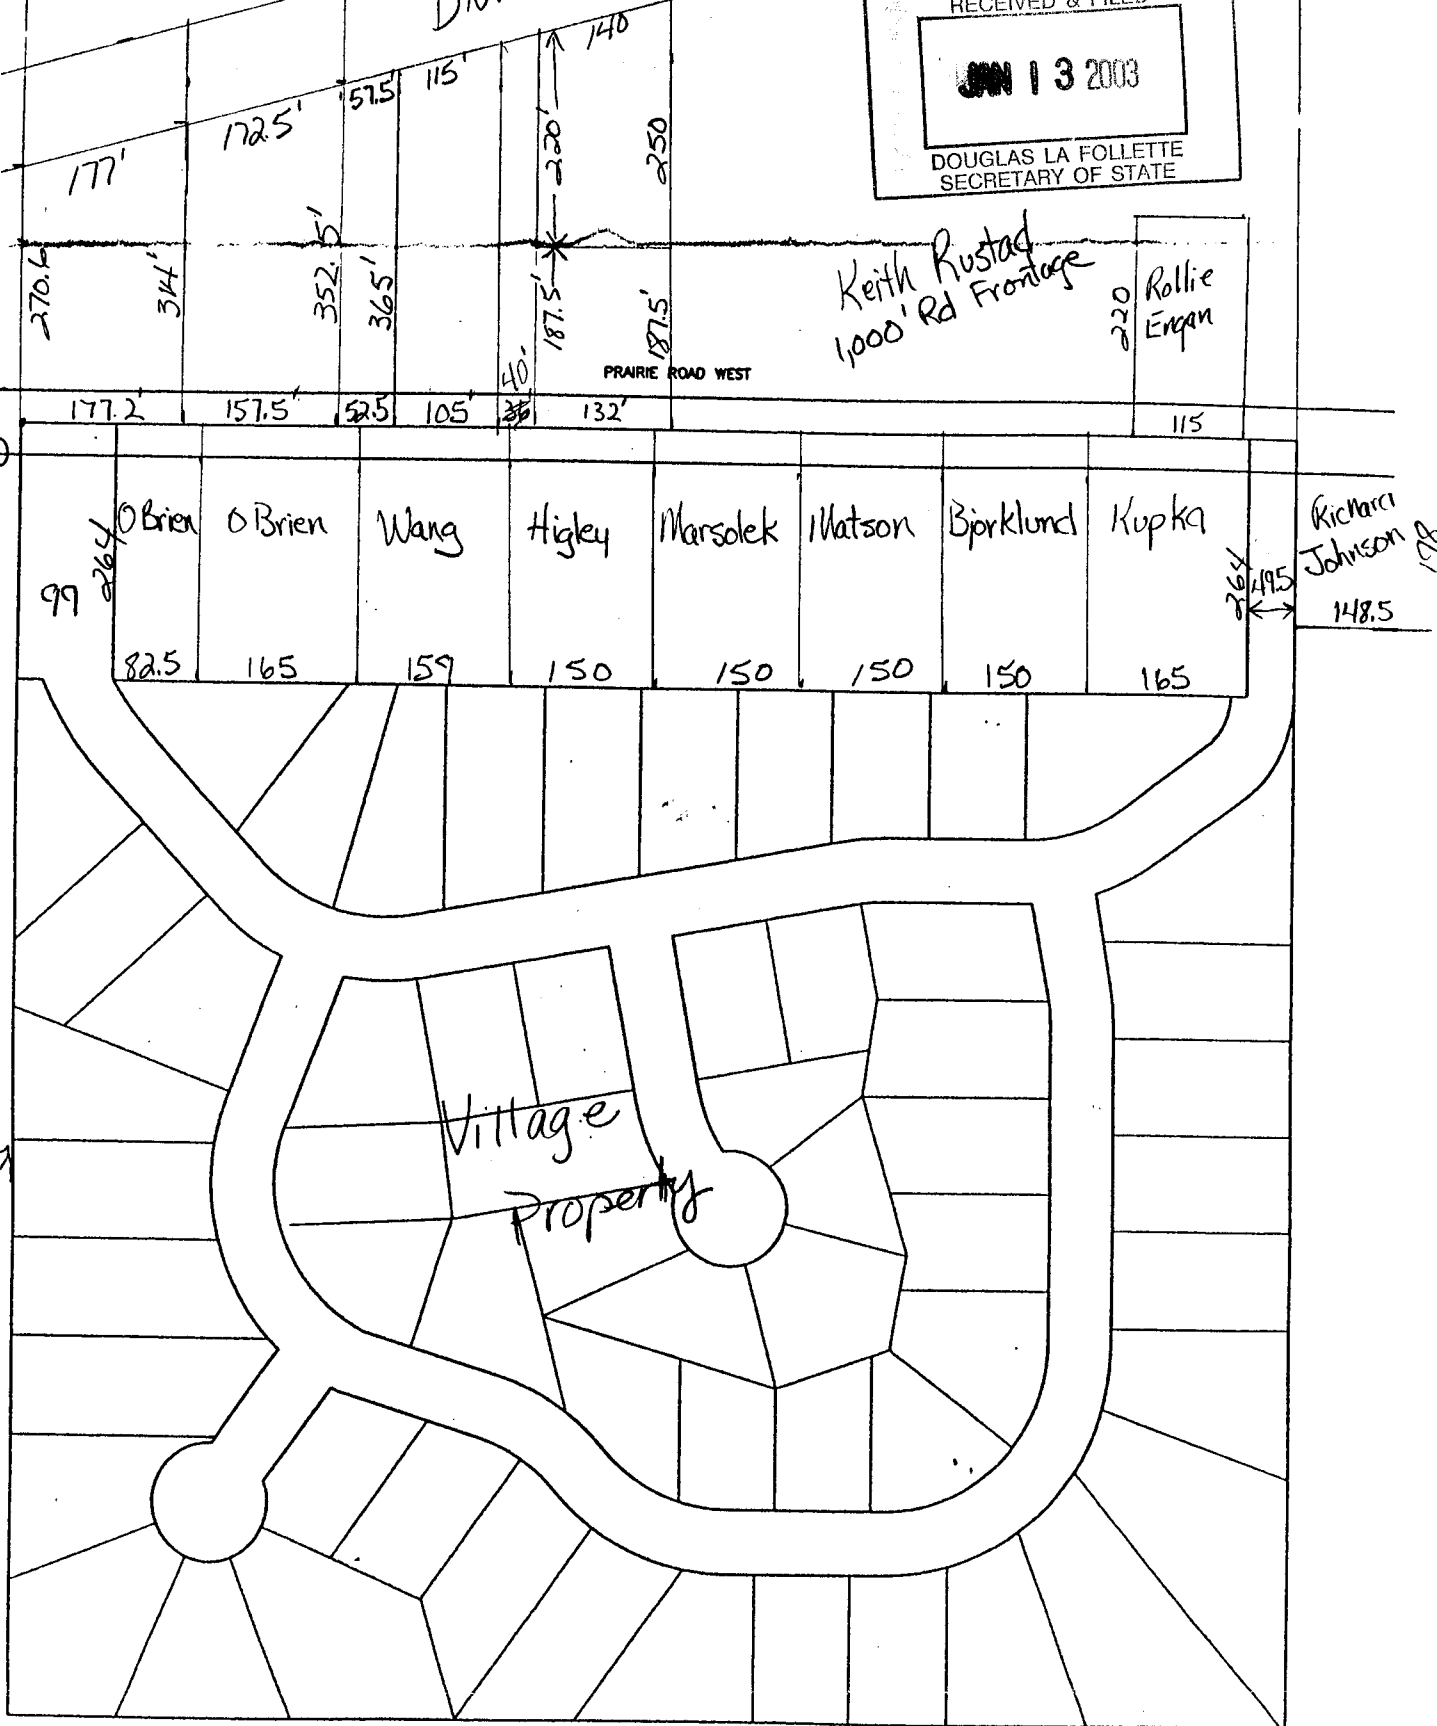

Sec. 20

T 24N R 8W



100 200

scale 1" = 200'




STRUM, WISCONSIN

SUBDIVISION LAYOUT

FILE NO.
STRUM0201.00

SHEET

DATE
10/2/02

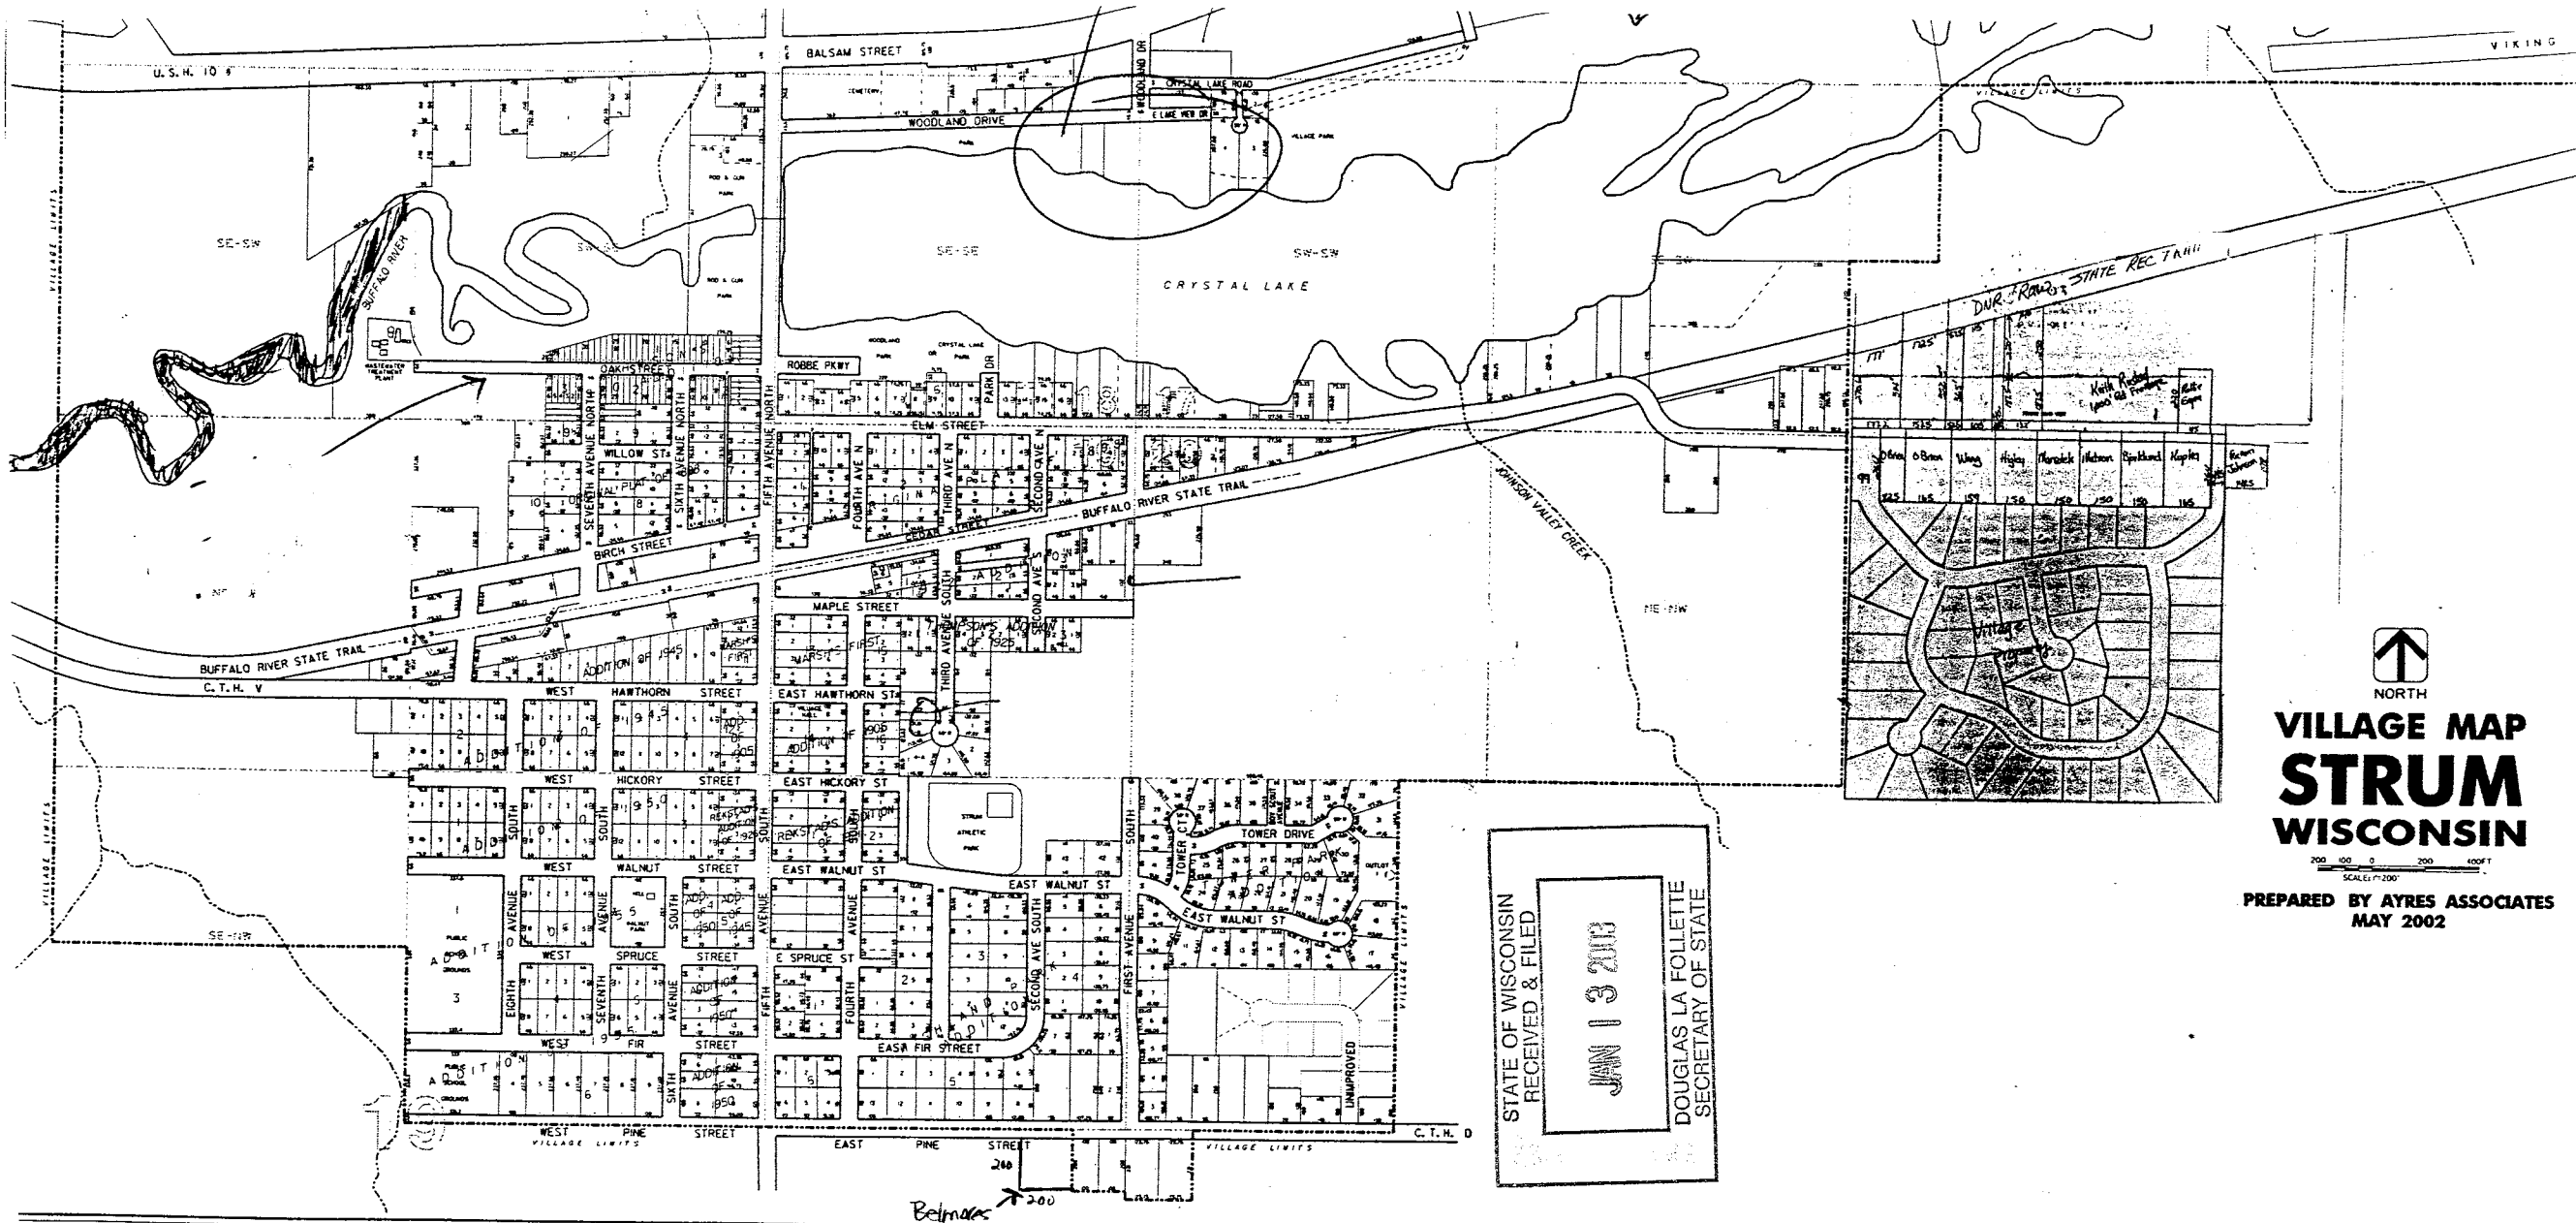

32 Acres Village Property Annexed 12-30-02
Ordinance # 91